


EDM (TS) Survey Map of Sita Vihar Vistar

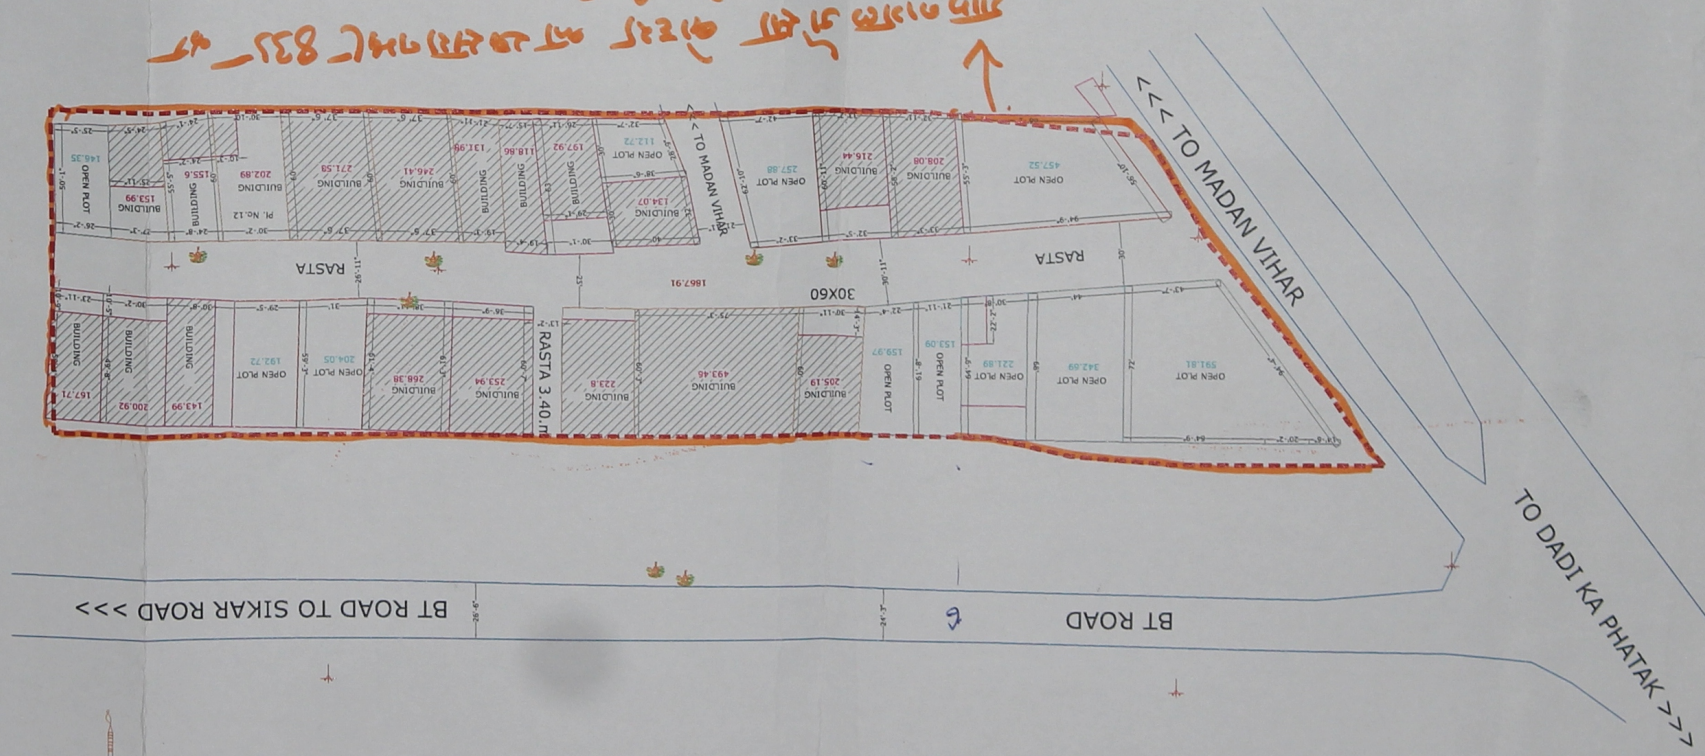

165

LEGEND	
[Red dashed line]	COLONY BOUNDARY
[Red solid line]	JOB PLOTS
[Hatched box]	BUILDING
[Red box with 'CW']	COMPOUND WALL
[Red box]	HUT
[Hatched box]	PAKKA HOUSE
[Hatched box]	KACHA HOUSE
[Red line]	B.T ROAD
[Red line]	C ROAD
[Blue circle]	TUBE WELL
[Red square]	TEMPLE
[Red cross]	TELEPHONE POLE
[Red cross]	ELECTRIC POLE
[Blue square]	WATER POND
[Blue circle]	HAND PUMP
[Blue line]	CULVERT
[Red line]	MED. POOLA
[Blue line]	DRAIN
[Green tree icon]	TREE
[Green grass icon]	GRASS



Handwritten orange text:
 835 - 47
 800375 0222
 800375 0222

S. No.	Particulars	AREA (Sq.Yds.)
1.	BUILTUP AREA	3995.21
2.	OPEN PLOT AREA	2840.69
3.	ROAD AREA	1867.91
4.	OPEN LAND AREA	514.76
5.	TOTAL AREA	9218.57

Title:-	
EDM (TS) Survey Map of SITA VISTAR	Under Jaipur Development Authority, Jaipur
Regulation of un-authorized Colonies, Commercial, Industries Established in Agricultural land.	(Surveyed Area : 3.05 Bigha)
Jaipur Development Authority, Jaipur	Agency:-
IPE Global Private Limited A-10, 2nd Floor, Green Park, Main Aurubindo Park New Delhi 110016, India	
Checked By:-	
AEN/Junior Engineer, Main Aurubindo Park, New Delhi 110016, India	
Submitted By:-	
IPE Global Private Limited A-10, 2nd Floor, Green Park, Main Aurubindo Park, New Delhi 110016, India	

- Observations :-
- 1- There are no High Transmission Lines crossing over the bounds of this colony.
 - 2- There are no Nallahs, Nadi, existing in this colony.
 - 3- There is no Pond existing in this colony.
 - 4- There are no Expressions, Sand dunes existing in this colony.
 - 5- The position/relations of the area have been shown on this map.
 - 6- No found/exists at site during the survey process.


Scale: 1" = 25'
 Date: 12/01/2022
 Surveyed by: AEN/Junior Engineer, Main Aurubindo Park, New Delhi 110016, India
 Checked by: AEN/Junior Engineer, Main Aurubindo Park, New Delhi 110016, India
 Submitted by: IPE Global Private Limited, A-10, 2nd Floor, Green Park, Main Aurubindo Park, New Delhi 110016, India

PROPOSED LAY-OUT PLAN OF 'SITA VIHAR EXT.'

AT BENAR ROAD - JAIPUR

SHRI JANITA HOUSING CO-OPERATIVE SOCIETY LTD - JAIPUR

REGISTRATION No. 1571/L

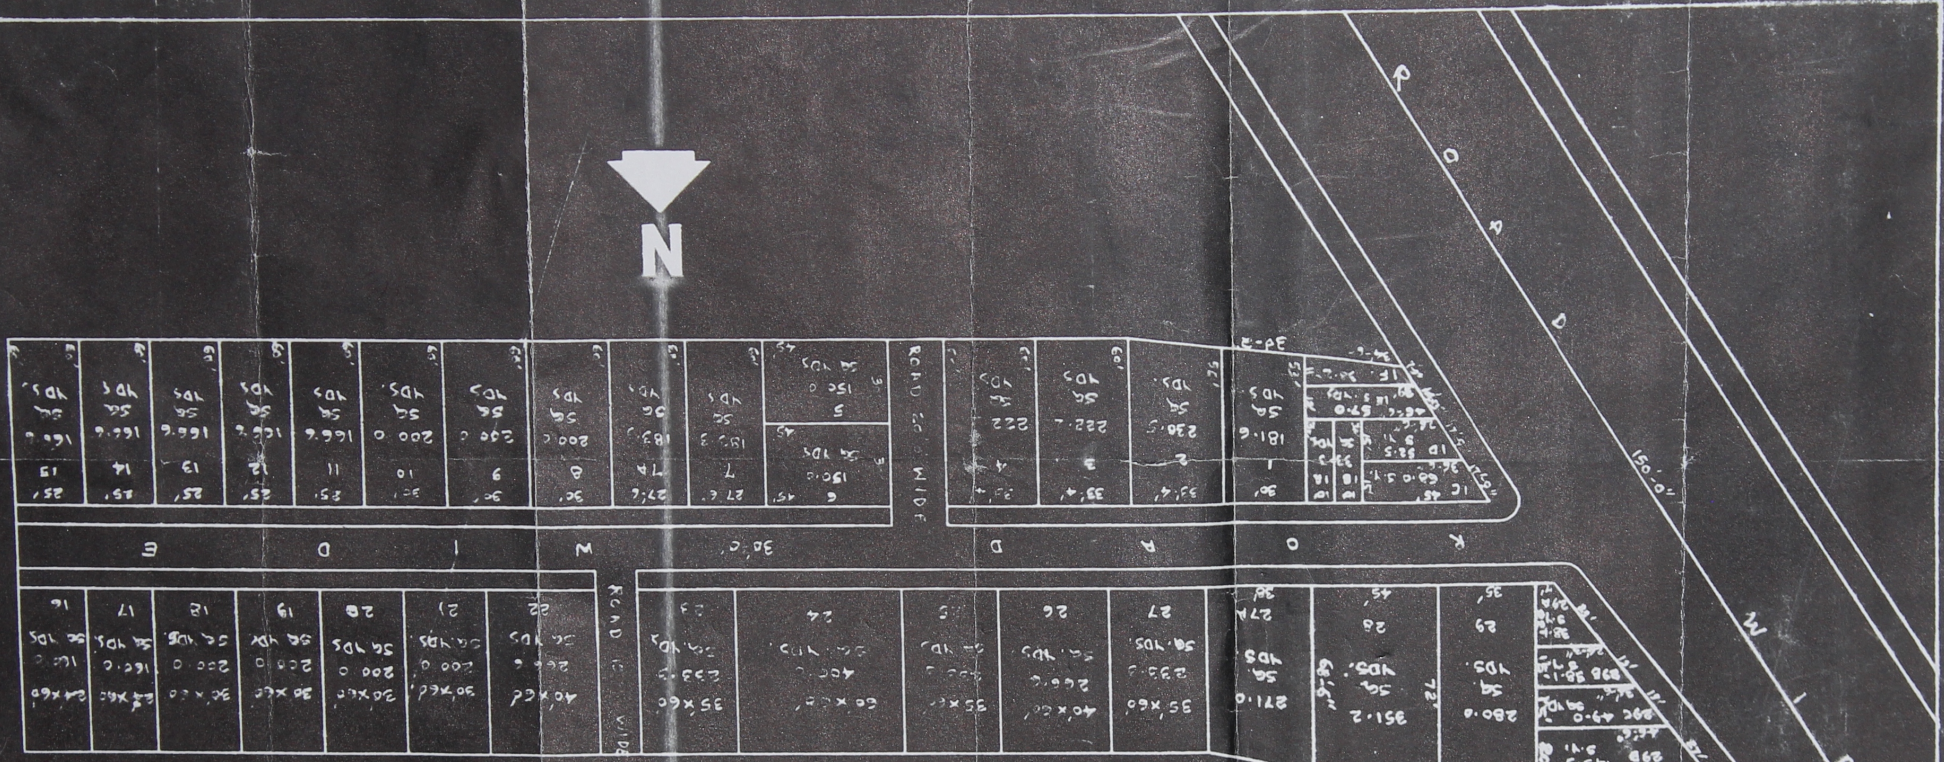

164
164