


- 1 FULLY BUILT UP SHOULD THUS
- 2 PARTIALLY
- 3 GARAGE
- 4 BOUNDARY WALL
- 5 LAYING VACANT
- 6 ROADS.
- (U) METALLED
- (M) W.B.M
- 7 SCHEME BOUNDARY.

REFERENCE:-

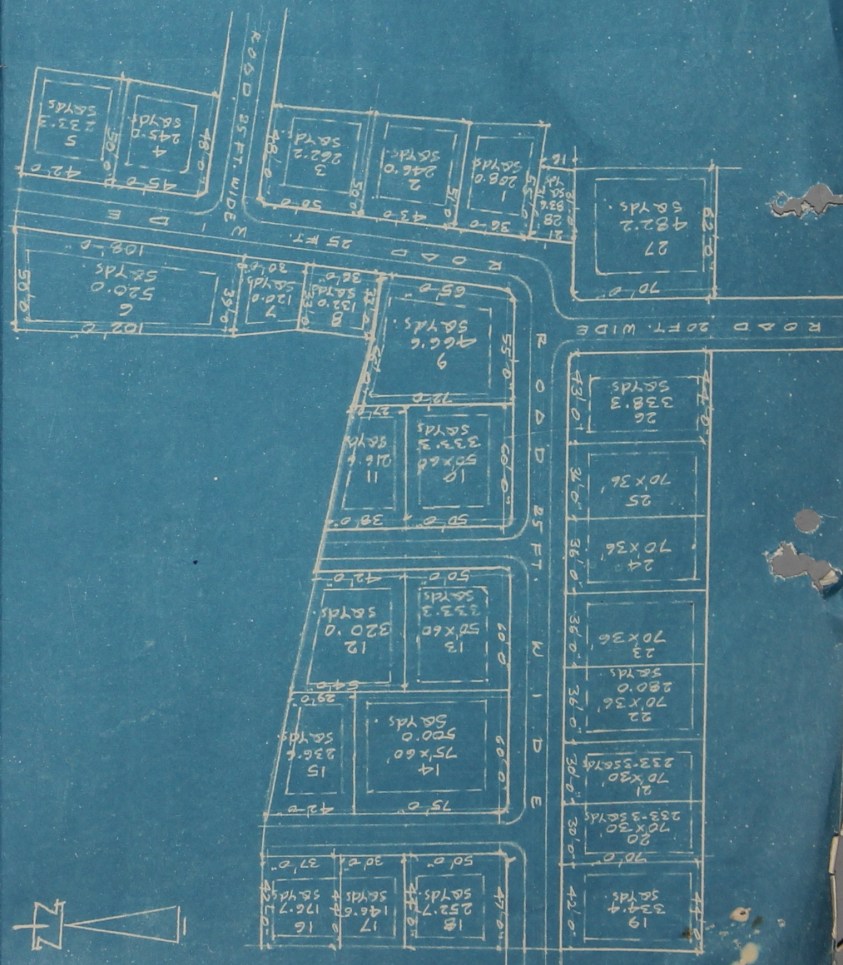

LAY OUT PLAN OF SCHEME NO. II OF

SINDHU NAGAR CO-OPERATIVE HOUSING SOCIETY
ON ROAD TO KHATIPURA ROAD JHOTWARA

SCALE 50 FT TO AN INCH


1. AREA OF PLOTS 7774.0 SARDS.
2. AREA OF ROADS 1980.0
- TOTAL AREA 9754.0 SARDS.

KEY PLAN
(NOT TO SCALE)



Secretary
Sindhu Nagar Co-Operative Housing Society Ltd.
JAIPUR

PRESIDENT

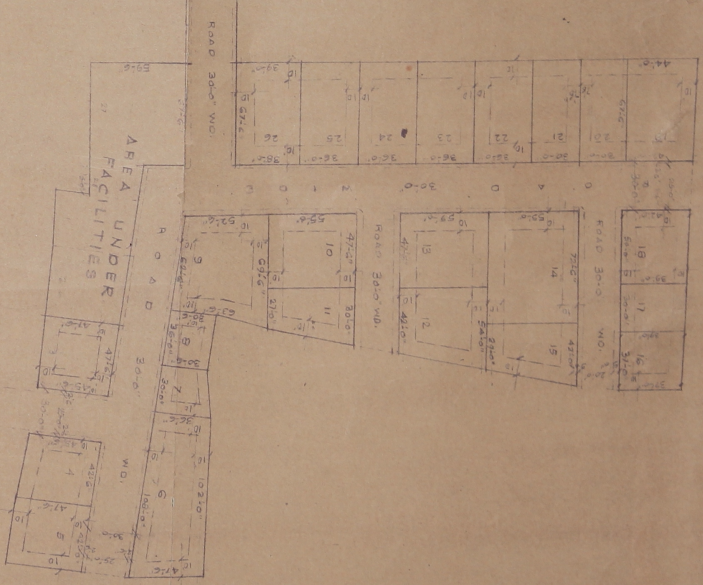

167

SECTOR No 17
SOCIETY SINDHU NAGAR
SCHEME No 11
LOCATION KHATTIPURA ROAD, JHOTWARA
 K.M. No. 8/11

J.D.A. *Jhotwar*
 SENIOR TOWN PLANNER

J.D.A. *Jhotwar*
 ASST. TOWN PLANNER

DEPT. B. H. SINGH
 SCALE: 1"=50'-0"

PROJ. No. 14/1973

USE	RESIDENTIAL	ROADS	FACILITIES	TOTAL
AREA IN ACRES	1.21	0.62	0.13	2.02
50.00	30.60	9.77	100.00	

RESIDENTIAL
 ROADS
 FACILITIES
 TOTAL

TOTAL NOS OF PLOTS APPROVED = 24
 APPROVED IN THE B.P.C. I 17th MEETING HELD ON 11/1/73

38

- 1 FULLY BUILT UP SHOWN THUS
- 2 PARTIALLY "
- 3 GARAGE
- 4 BOUNDARY WALL
- 5 LAYING VACANT
- 6 ROADS
- (U) METALLED
- (M) W.B.M.
- 7. SCHEME BOUNDARY.


REFERENCE:-

LAY OUT PLAN OF SCHEME NO. 11 OF
SINDHU NAGAR CO-OPERATIVE HOUSING SOCIETY
ON ROAD TO KHATIPURA ROAD JHOTWARA.

SCALE 50 FT TO AN INCH

Secretary
Sindhu Nagar Co-operative Housing Society Ltd.
JAPUR

TRASPARENT.

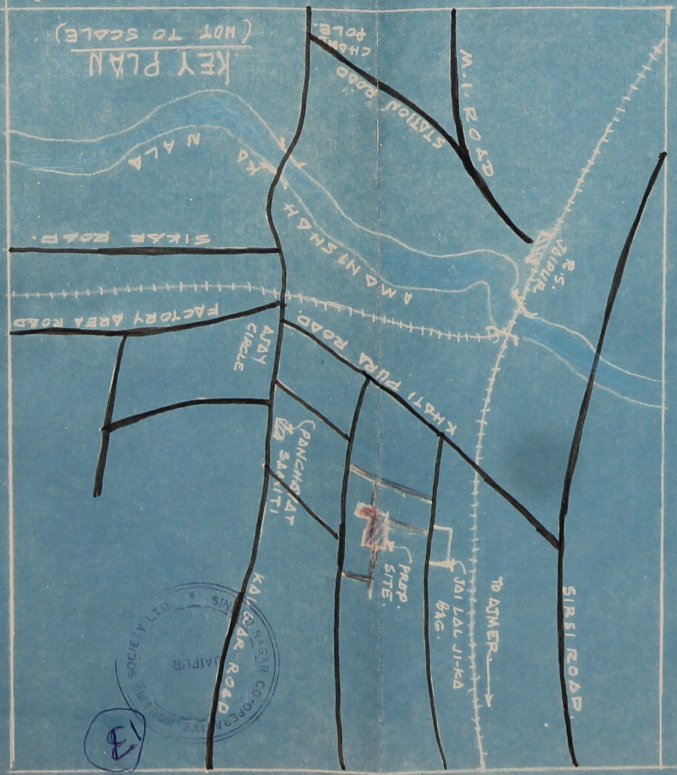

11


- 1 FULLY BUILT UP SHOW THUS
 2 PARTIALLY
 3 GARAGE
 4 BOUNDARY WALL
 5 LAYING VACANT
 6 ROADS.
 (U) METALLED
 (II) W.B.M.
 7. SCHEME BOUNDARY:

LAY OUT PLAN OF SCHEME NO II OF
 SINDHU NAGAR CO-OPERATIVE HOUSING SOCIETY
 ON ROAD TO KHATIPURA ROAD JHOTWARA.
 SCALE SOFT TO AN NCH

Use	Area in plots	Area	%
Roads	0.62	30.68	
Facilities	0.19	9.32	
Total	2.02	100.00	

1. AREA ~~77~~ 4.0 SAZDS.
 2. AREA ~~19~~ 60.0
 TO TOTAL AREA 9754.0 SAZDS.

Approved in the BRC 17th
 meeting held on 1.11.63.

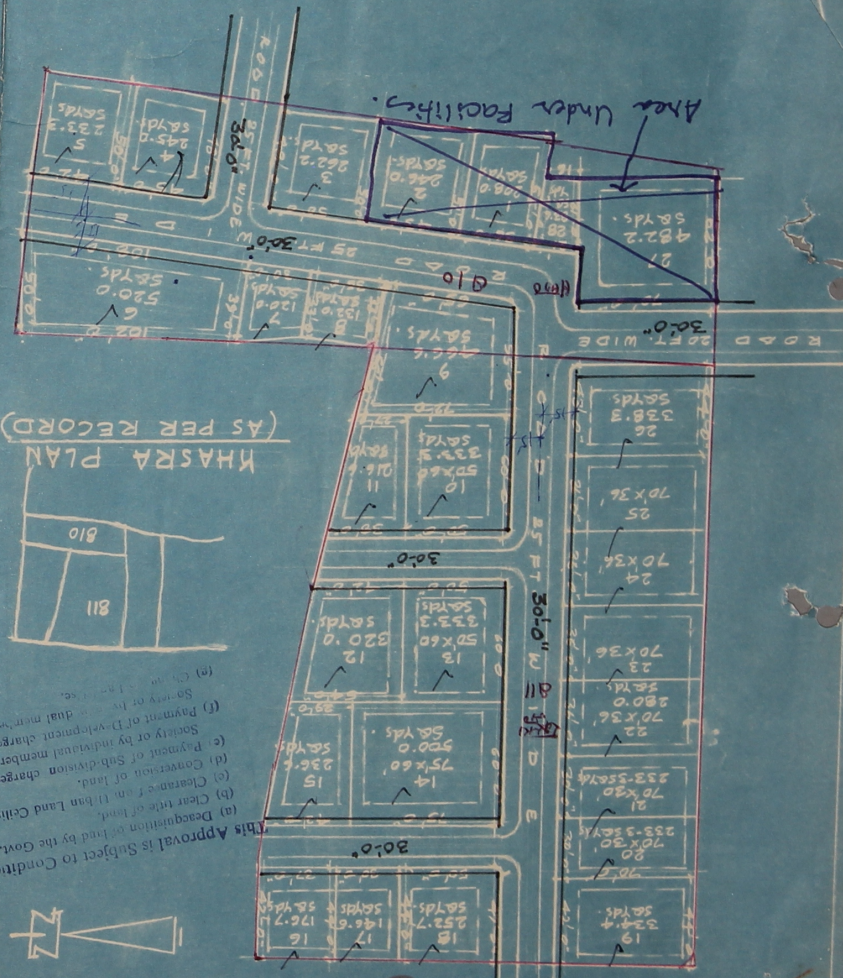

KHASTARA PLAN
 (AS PER RECORD)

- This Approval is Subject to Condition
- Deacquisition of land by the Govt.
 - Clear title of land.
 - Conversion of land.
 - Payment of Sub-division charges by Society or by individual member.
 - Payment of Development charges by Society or by individual member.
 - Clear title of land.



KEY PLAN
 (NOT TO SCALE)




107